


GENERAL CONSTRUCTION NOTES

1. CONTRACTOR SHALL BE RESPONSIBLE TO MEET ALL STATE AND LOCAL CODES REQUIRED FOR THIS PROJECT.
2. OWNER SHALL COORDINATE FINAL COLORS / FINISHES WITH THE CONTRACTOR PRIOR TO CONSTRUCTION.
3. ALL GRADES SHOWN ON ELEVATIONS ARE APPROXIMATE ONLY, FIELD VERIFY CONDITIONS PRIOR TO ANY CONSTRUCTION.
4. PRE-ENGINEERED METAL BUILDING SHALL BE CERTIFIED BY BUILDING MANUFACTURER BY A REGISTERED ENGINEER LICENSED IN THE STATE OF MARYLAND.
5. BUILDING SHALL BE FULLY INSULATED WITH MANUFACTURERS INSULATION.
6. OWNER IS TO PROVIDE FIRE EXTINGUISHERS (F. E.) AS INDICATED ON PLANS TO MEET NFPA STD 10.

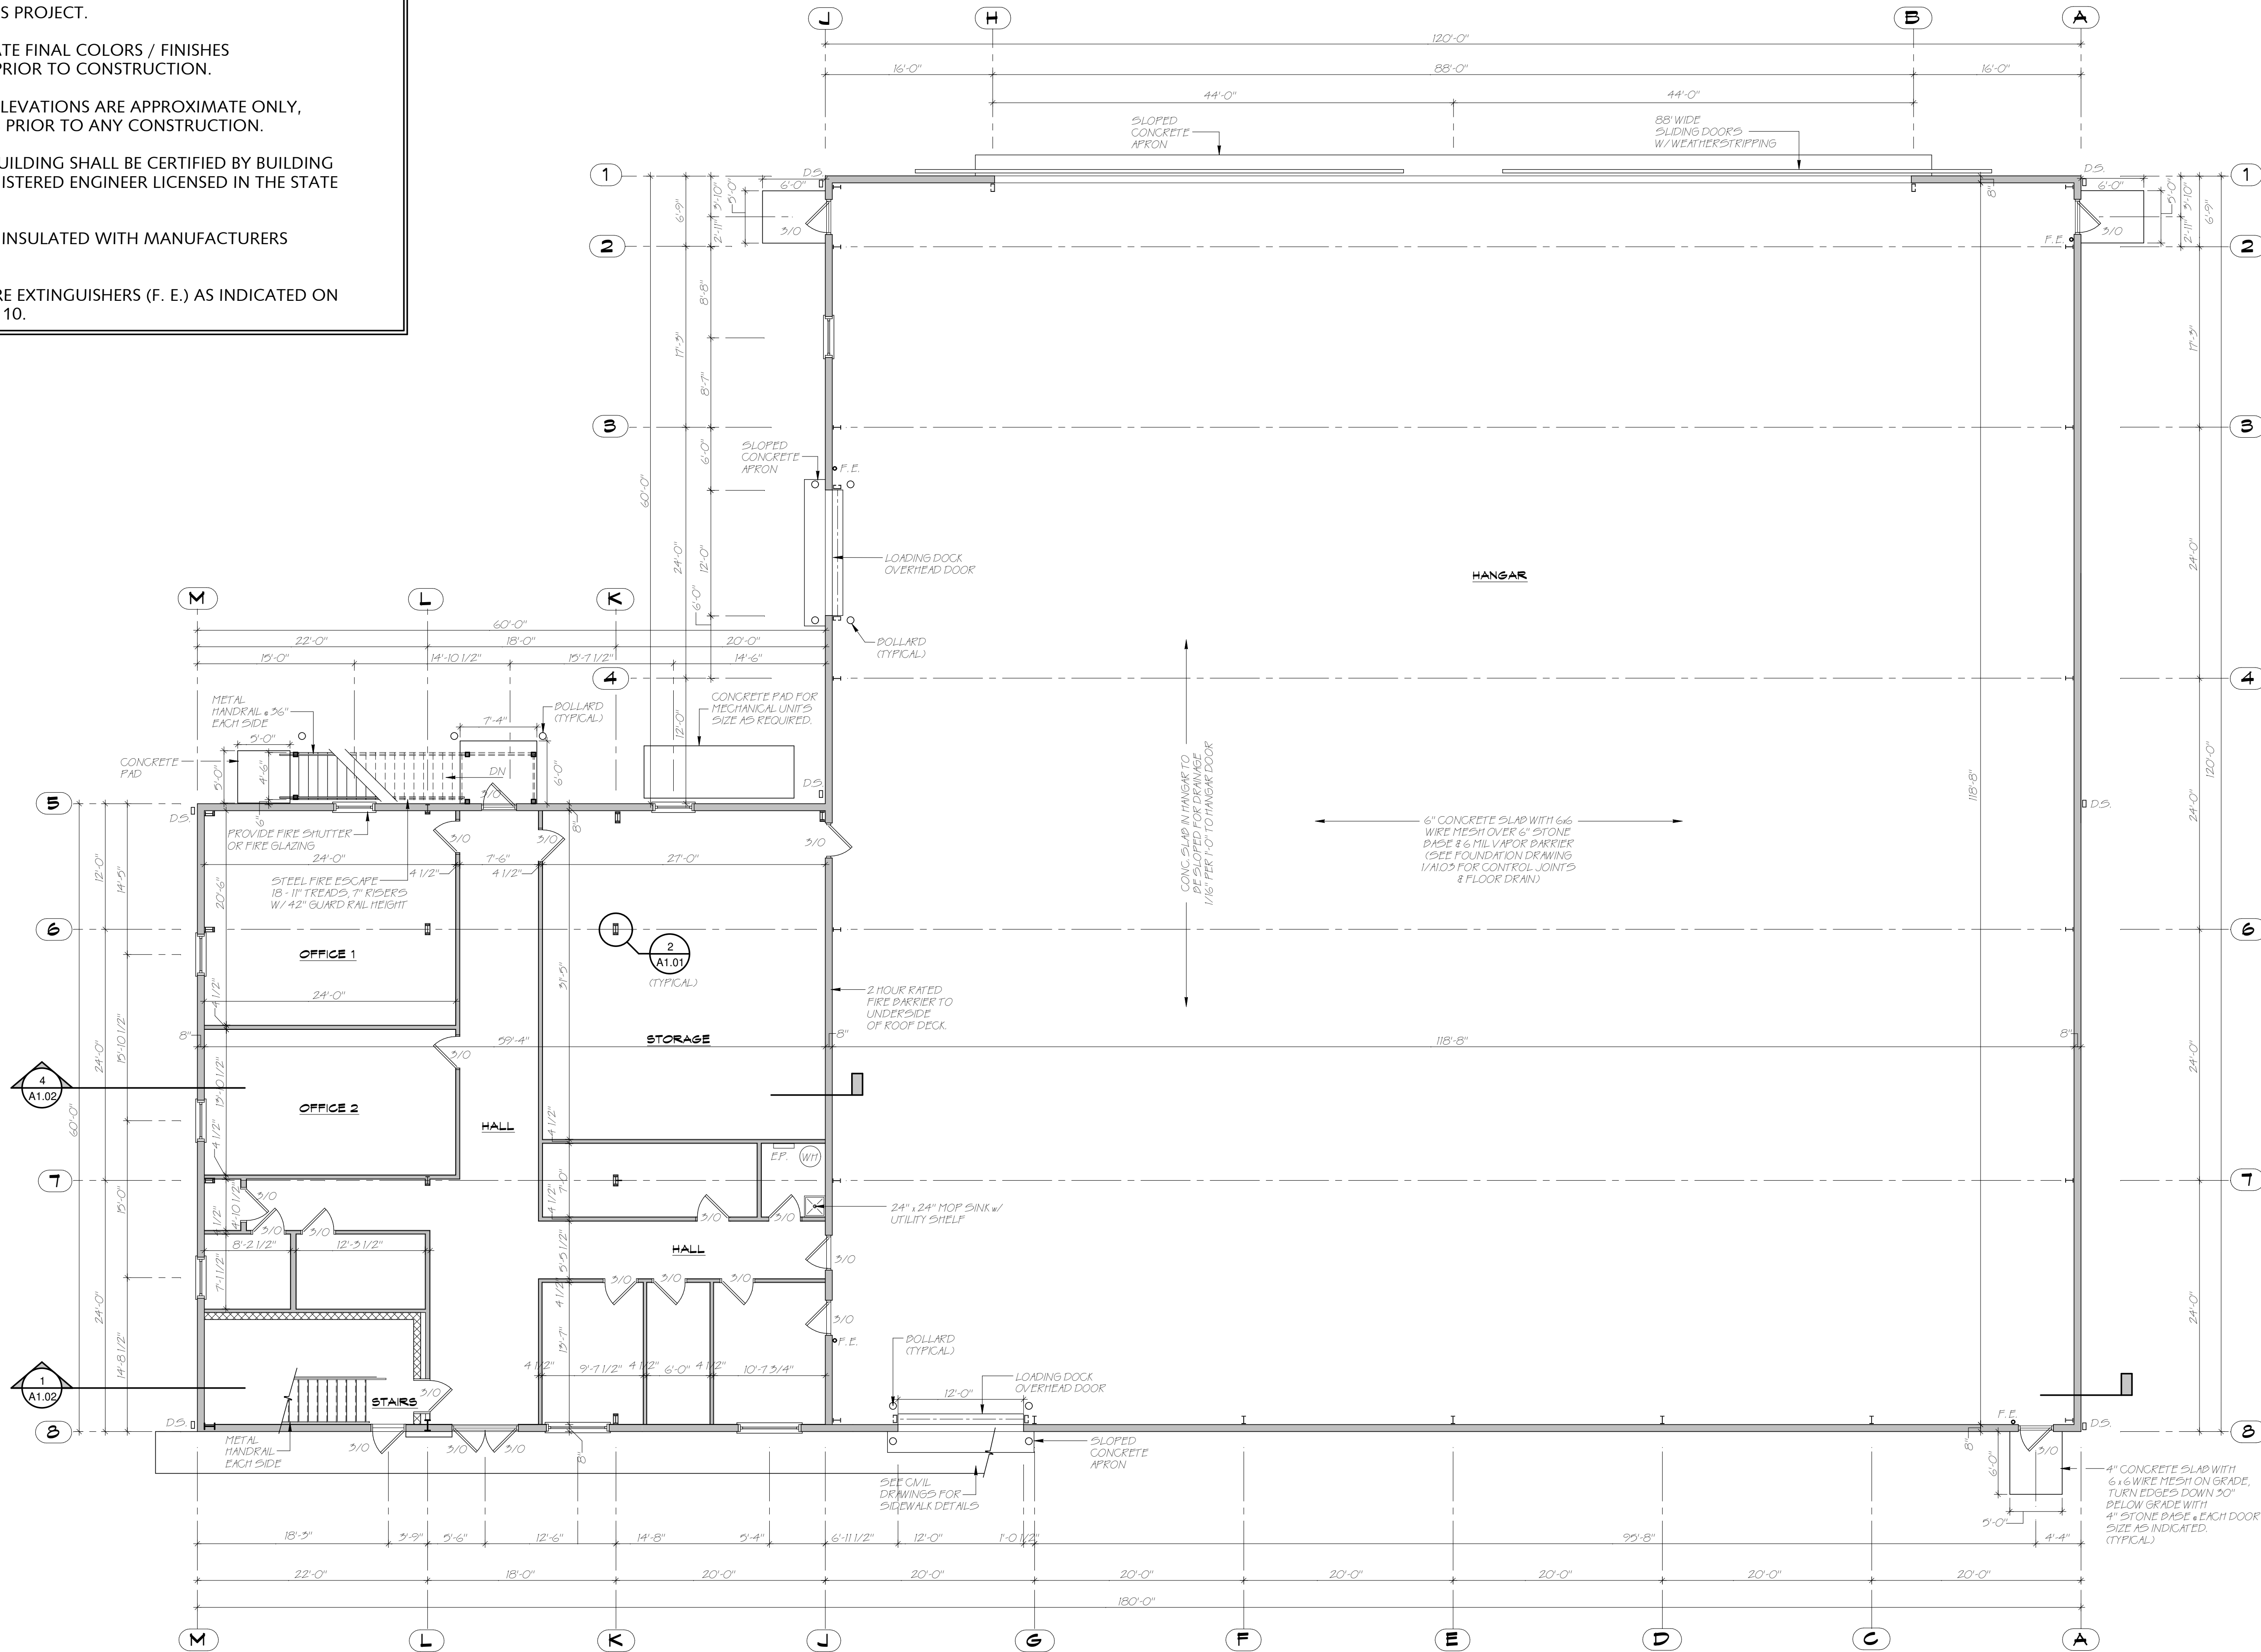

FIRST FLOOR PLAN

SCALE: 1/8" = 1'-0"

DIMENSION NOTE:
PLAN DIMENSIONS ARE SHOWN FROM THE FOLLOWING: OUTSIDE
FACE OF EXIST. WALLS OUTSIDE OF NEW FRAMING NOT INCLUDING
SHEATHING, MASONRY WALLS (NOT INCLUDING FINISHES),
COLUMN CENTERLINE, FACE OF INT. MASONRY WALLS AND FACE
OF INT. FRAMING NOT INCLUDING GWB. AND FINISHES, UNLESS
INDICATED OTHERWISE. ALL M.S. SHOULD BE VERIFIED PRIOR TO
CONSTRUCTION. PLANS SHOULD BE READ NOT SCALED!

BMGM ARCHITECTS p.c.

18129 Oak Ridge Drive
Hagerstown, Maryland 21740
Phone - (301) 797-9520
Fax - (301) 797-9521

I CERTIFY THAT THESE DOCUMENTS WERE PREPARED
OR APPROVED BY ME, AND THAT I AM A DULY
LICENSED ARCHITECT UNDER THE LAWS OF THE
STATE OF MARYLAND.

LICENSE NO. EXPIRATION DATE:

NEW AIRCRAFT HANGAR FOR:

FALCON AIR
AIRPARK DRIVE HAGERSTOWN, MD.

BMGM ARCHITECTS p.c.

18129 OAK RIDGE DRIVE, HAGERSTOWN, MARYLAND 21740
(PHONE) 301-797-9520 (FAX) 301-797-9521 -- WWW.BMGMARCHITECTS.COM

FIRST FLOOR PLAN (AS-BUILT)

PROJECT NORTH

SHEET
A1.01
NUMBER

DATE
02 OCTOBER 2008
SCALE
AS NOTED
BMGM PROJECT No 0831 DRAWN BY DRC

COPYRIGHT 2008 BMGM ARCHITECTS
AS-BUILT
DRAWINGS