




DWG/PN: 47-104660-01 REV.A0
DWG/PN: 471-100430-03 REV. A0
AW#:56-103799-01 REV.A0
CUST.Ben Rubenson
ARTWORK PROOF: 2, added "." to web address

ARTWORK-POD

NOTE:

BLUE BOXES ARE DYNAMIC FIELDS TO BE ENTERED BY CM SITE
SEE CISCO BOM/SPEC FOR MORE DETAILS.

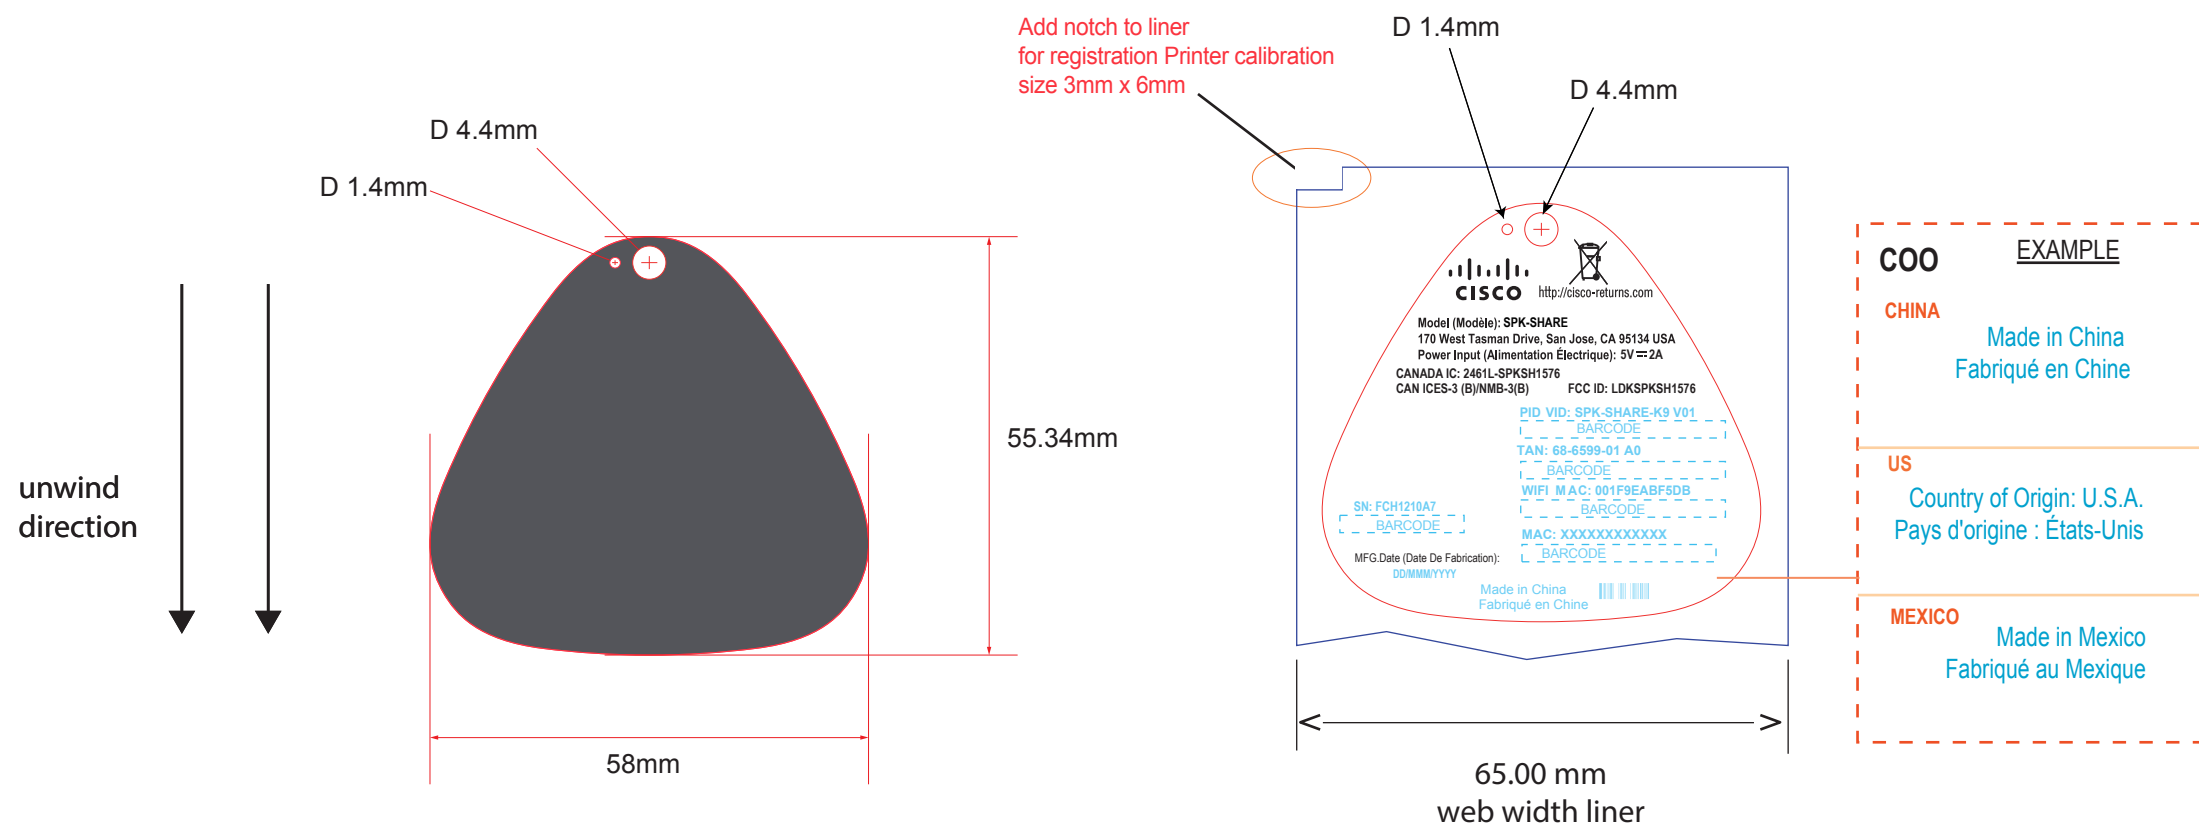

Cross hatch indicates through cut

NOTES:	
A) Material	
Mat Ref: CCL 339 with matte finish	
Ribbon: DPW6000 (Off White Color)	
B) COLORS	C) FONTS
1) Background Pantone Cool Gray 11C	1)
2) Varnish	2)
3)	3)
4)	4)
5)	5)
6)	6)
7)	7)
8)	8)

LABEL FINISHED COPY:
LABELS/TILE:
TILES/PACK:
LABELS/PACK:
Matrix Strip: <input checked="" type="checkbox"/> N

IMPORTANT

DELIVERY TIME CAN ONLY BE MET WITH YOUR COOPERATION. PLEASE ENSURE THE ARTWORK PROOF IS CHECKED CAREFULLY FOR LAYOUT, WORDING, SPELLING, SIZE, COLOR, ETC., THEN, RETURNED WITHIN 24 HOURS, TO ENSURE DELIVERY SCHEDULES ARE MET. THE COLORS DISPLAYED ON THIS PROOF MAY NOT BE ACCURATE; REFER TO PMS OR CISCO COLOR BOOK REFERENCES STATED FOR TRUE REPRESENTATION.

Approved By: _____

Title: _____ Date: _____

WM REF. No.	Rev.	Description	ECN
Artist: Chan/Wes		DATE: 03/13/18	

Red Line is cut line

Dimensions are shown in imperial (metric)
Tolerances unless otherwise specified are:

Dimensions Tolerance: ± 0.30mm

P2C Tolerance: ± 0.30mm

UNIT: mm

SCALE: 1:1

SHEET: 1 of 1