
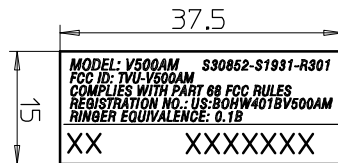


V500AM BASE

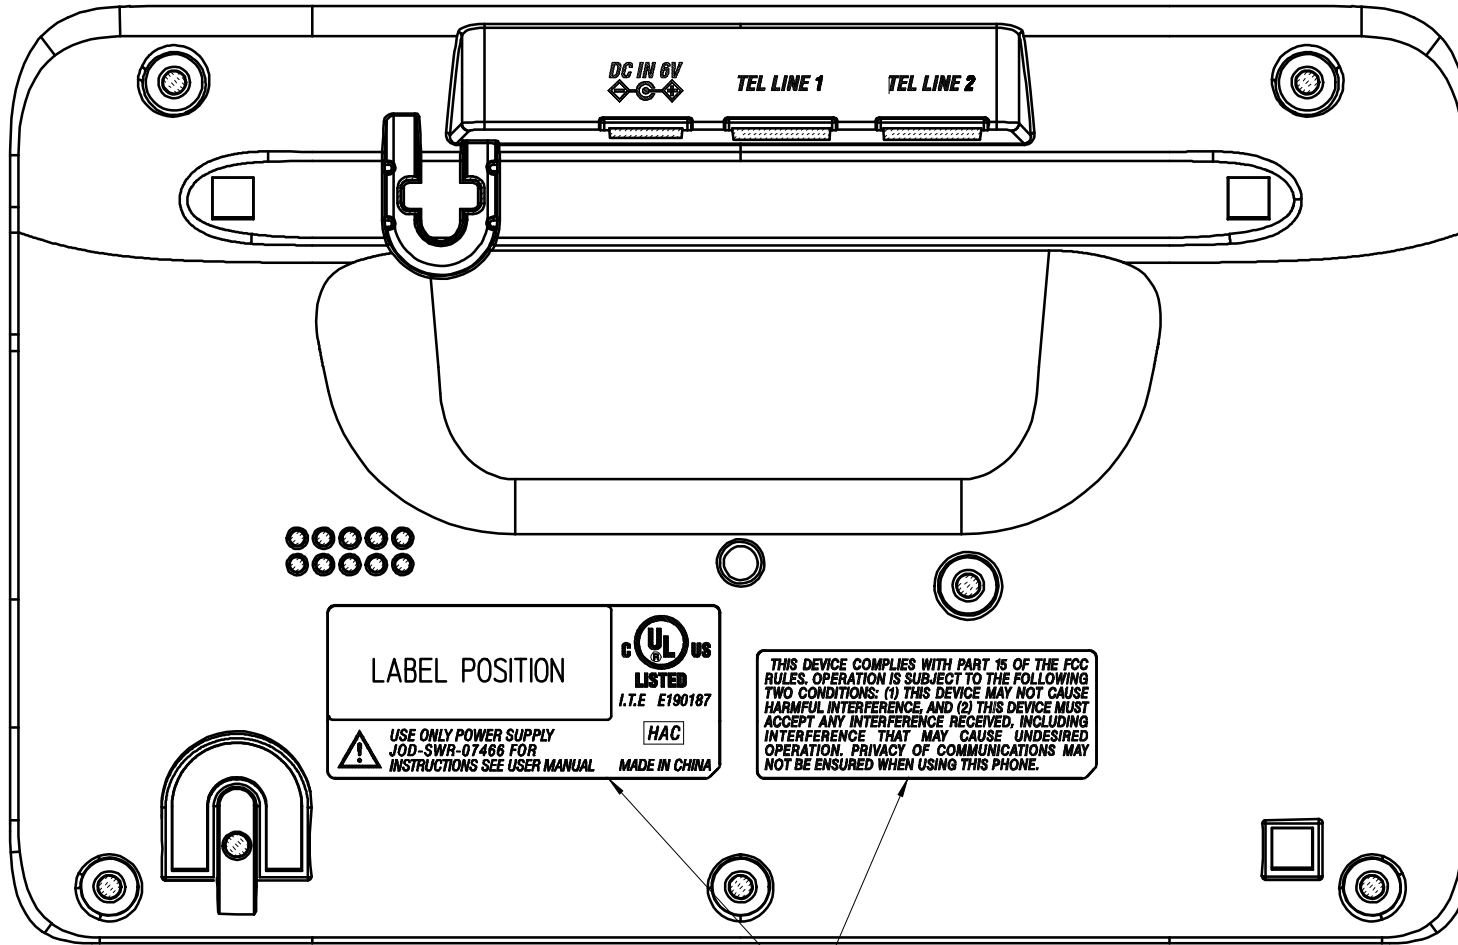

LABEL


ENGRAVE

CAUTION:
MATERIAL MUST BE MET DIRECTIVE 94/62/EC AS FOLLOWS:
THE FOLLOWING SUBSTANCE TOTAL CONTENTS SHOULD BE LESS THAN 100ppm
(1) Cadmium and Cadmium Compounds
(2) Hexavalent Chromium Compounds
(3) Lead and Lead Compounds
(4) Mercury and Mercury Compounds
MATERIAL MUST BE MET DIRECTIVE 2002/95/EC(RoHS) AS FOLLOWS
THE FOLLOWING SUBSTANCE EACH CONTENT SHOULD BE LESS THAN 1000ppm
(5) Polybrominated Biphenyls(PBBs)
(6) Polybrominated Diphenyl ethers(PBDEs)
At the time of parts approval request you have to prove and gurantee that the material comply with the above requirement by attaching SAMPLE and 'GREEN PROCUREMENT BASIC INFORMATION SURVEY (CHEMICAL SUBSTANCE) TABLE'
When material is changed after parts approval,it necessary to do same thing again.

GENERAL TOLERANCE						
	G	H	J	K	L	
~ 8	±0.1	±0.1	±0.2	±0.2	±0.4	
8up ~ 25	±0.15	±0.15	±0.3	±0.3	±0.6	
25up ~ 80	±0.2	±0.25	±0.4	±0.5	±0.8	
80up ~ 250	±0.3	±0.4	±0.6	±0.8	±1.2	
250over	±0.6	±0.8	±1.0	±1.5	±2.0	

DO NOT SCALE DRAWING

REGISTRATION NO.: US:BOHW401BV500AM

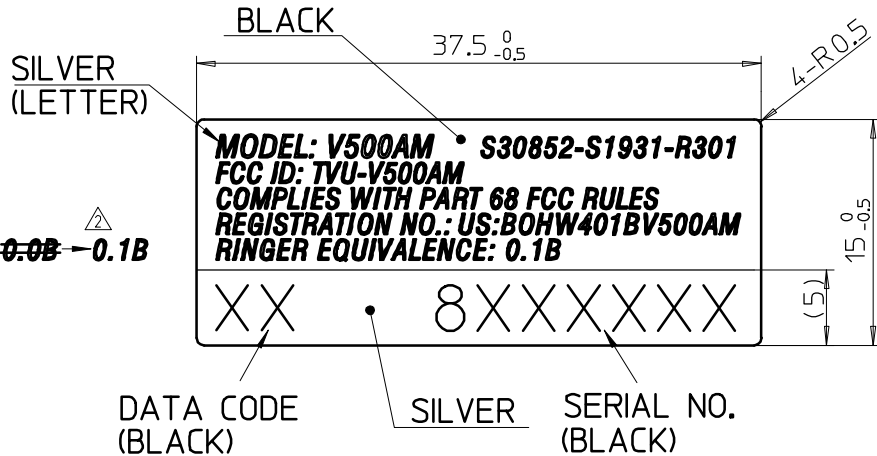

INDICATION OF DATA CODE

XX

Encoding (Month)
EX: Jan -- 1 Jul -- 7
Feb -- 2 Aug -- 8
Mar -- 3 Sep -- 9
Apr -- 4 Oct -- 0
May -- 5 Nov -- N
Jun -- 6 Dec -- D

Encoding (Year)
EX: 2008 -- W 2011 -- B
2009 -- X 2012 -- C
2010 -- A 2013 -- D

INDICATION OF SERIAL NO.

8XXXXXXXXX

SEIAL NO. 000001 ~ 999999
STARTS FROM 000001 EVERY YEAR

MODEL CODE
8 -- UC954ZH (V500AM DUO)

NOTE

- MATERIAL :POLYESTER TRCK FORM (MATT) SILVER (T=0.05)
UL RECOGNIZED COMPONENT UNDER THE CATEGORY OF MARKING AND LABELING SYSTEMS (PGDQ2)
- PRINT COLOR:BLACK
- ARTWORK :PC DATA D11536 ~~D11438~~ ~~D10744~~
- LAMINATE :POLYPROPYLENE (GLOSS) CLEAR T0.025
- ADHESIVE STRENGTH : MORE THAN 1000g/25mm (180° PEEL OFF TEST)

△				ENG'G. DIM. REQMT. FOR UNIDEN IQC INSP				YES	NO
3	CHANGE ARTWORK D11536 (REGISTRATION NO ***401***)	ABE JUN.17'08	JOE JUN.17'08	ABE JUN.17'08	APPROVED BY	CHECKED BY	DESIGNED BY	DRAWN BY	
2	CHANGE ARTWORK D11438 (RINGER EQUIVALENC 0.1B)	ABE JUN.06'08	SATO JUN.06'08	ABE JUN.06'08	ABE Mar.31'08	ABE Mar.31'08	ABE Mar.19'08	ABE Mar.19'08	
1	CORRECT DATA CODE	ABE Apr.22'08		ABE Apr.22'08	MODEL PARTS NAME				
REV.MARK	CONTENTS	REVISED	CHECKED	APP'VD	UC-954Z		LABEL:ID		
ANGLE	UNITS	TOLERANCE	SCALE	MOLD CAVITIES	TOOL CODE	BASIC MODEL	BASIC PARTS CODE	PARTS CODE	
⊕	m m	-	2:1	- pcs	-	-	-	PLBS4D8962Z	