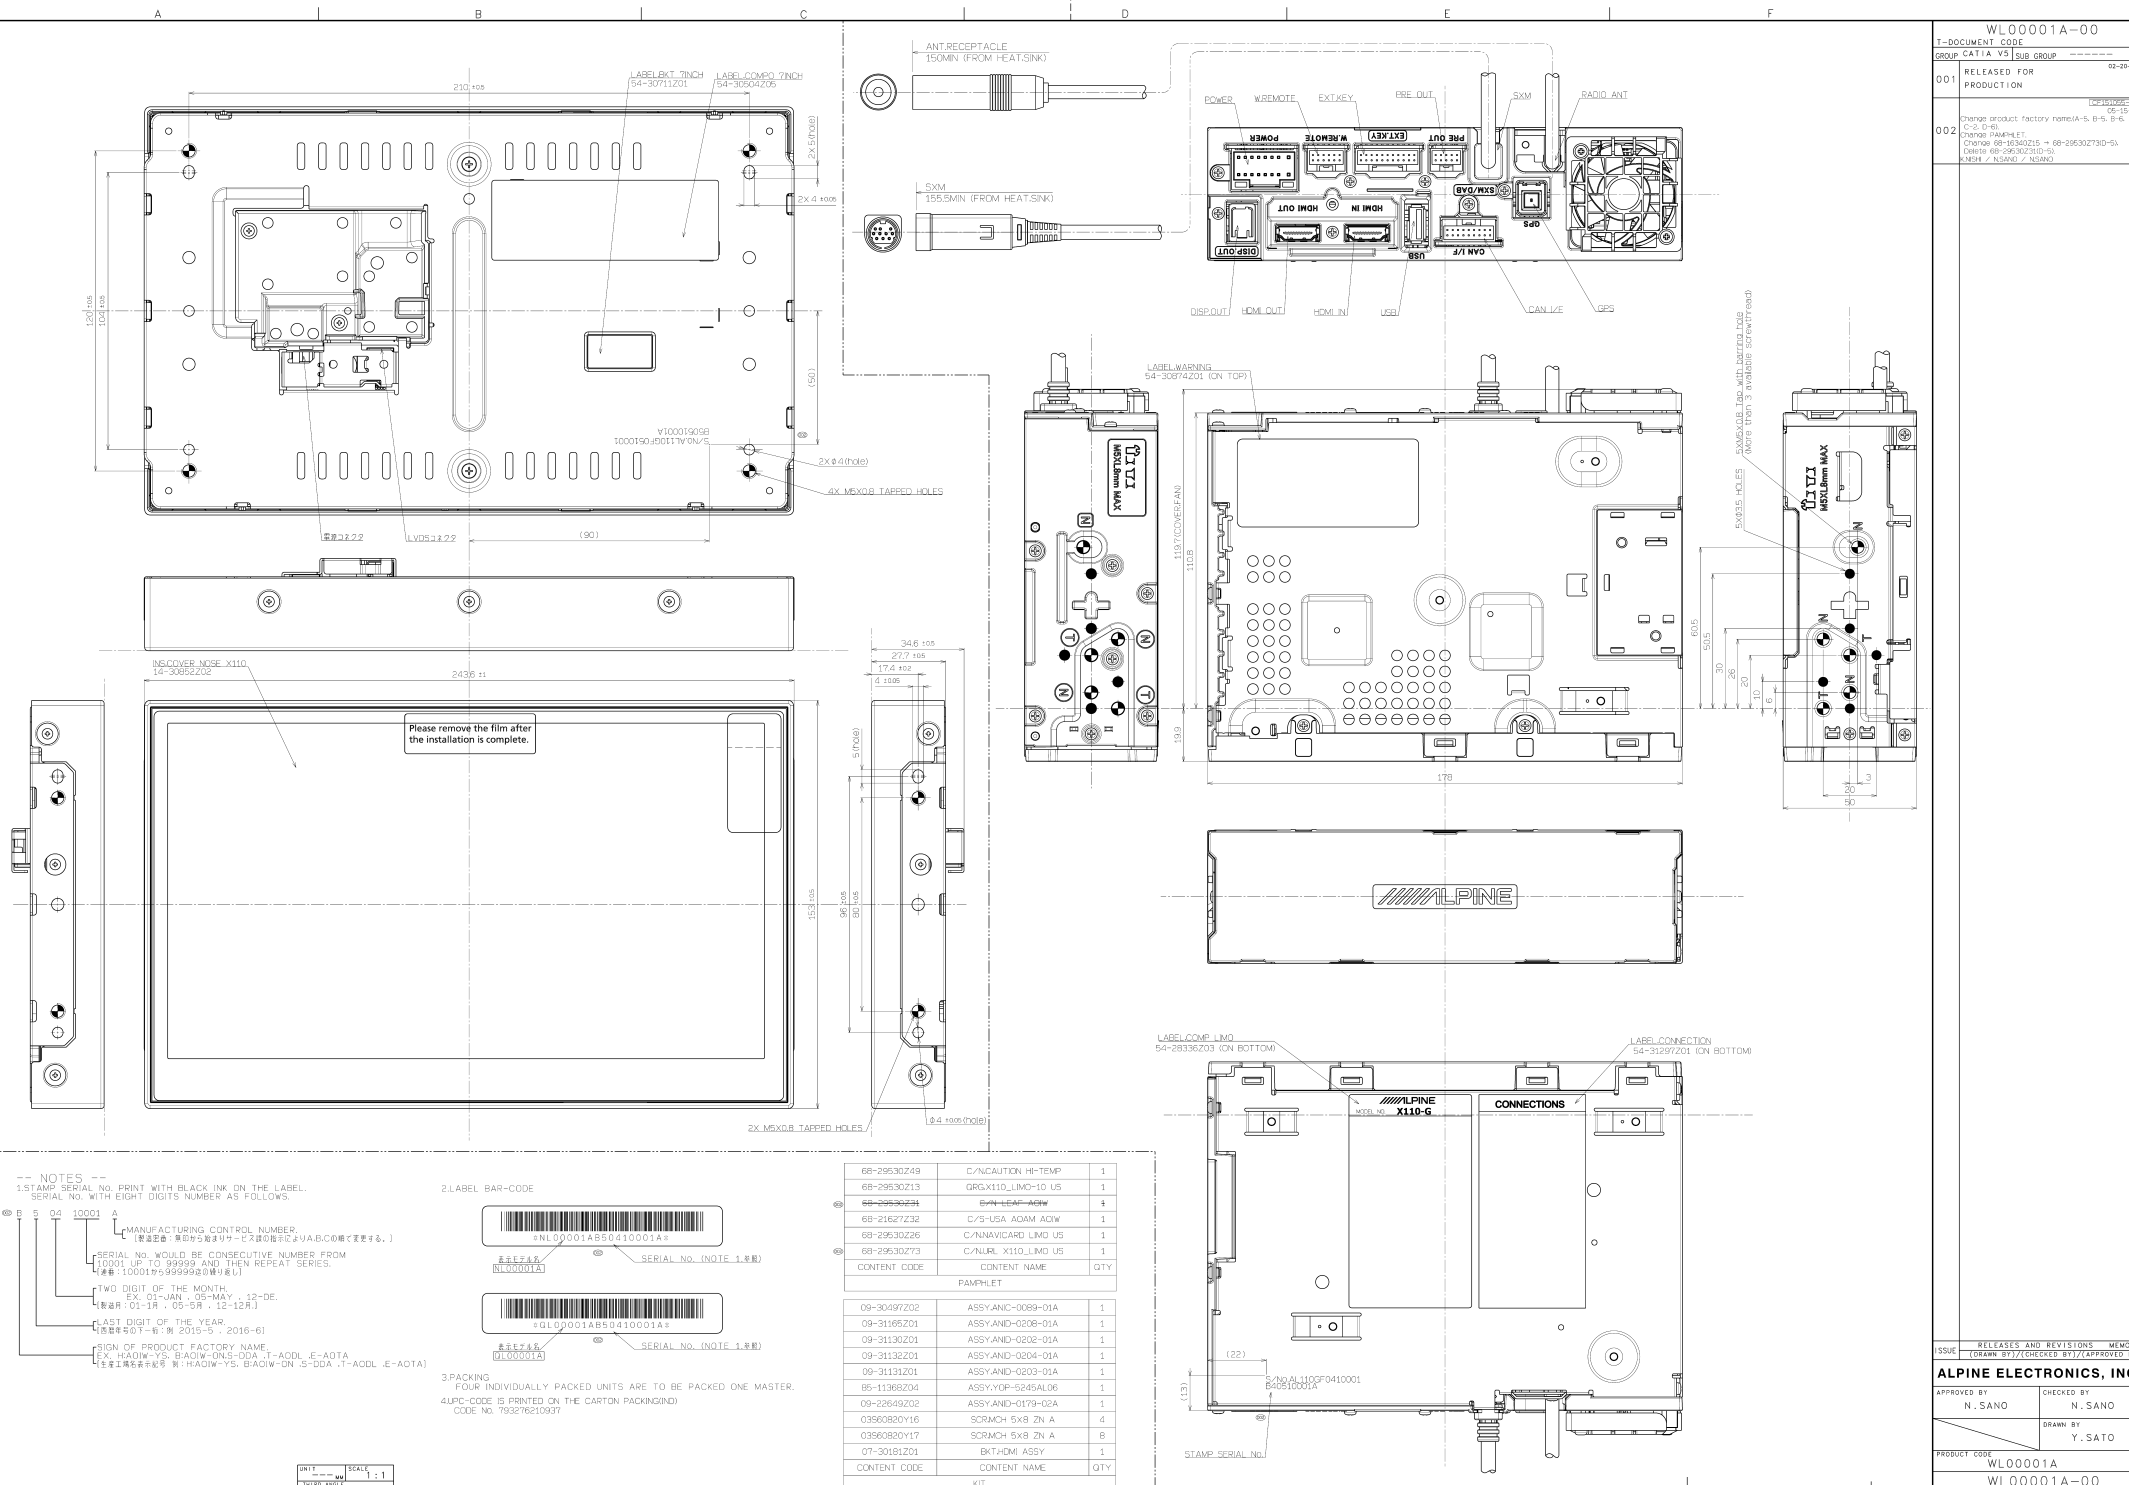

-- NOTES --

1.STAMP SERIAL No. PRINT WITH BLACK INK ON THE LABEL.
SERIAL NO. WITH EIGHT DIGITS NUMBER AS FOLLOWS.

B 5 04 10001 A

- MANUFACTURING CONTROL NUMBER. (製造記番：英のから始まりサービス課の指示によりA,B,Cの順で変更する。)
- SERIAL No. WOULD BE CONSECUTIVE NUMBER FROM 10001 UP TO 99999 AND THEN REPEAT SERIES. (連番：10001から99999迄の繰り返し)
- TWO DIGIT OF THE MONTH. EX. 01-JAN , 05-MAY , 12-DE. (製造月：01-1月 , 05-5月 , 12-12月)
- LAST DIGIT OF THE YEAR. (西暦年号の下一桁：例 2015-5 , 2016-6)
- SIGN OF PRODUCT FACTORY NAME. EX. HAOIW-YS, B:AOIW-ON,S-DDA ,T-AODL ,E-AOTA (生産工場名表示記号 例：HAOIW-YS, B:AOIW-ON ,S-DDA ,T-AODL ,E-AOTA)

2.LABEL BAR-CODE

≡NL00001AB504100001A≡
表示モデル名 NL00001A
SERIAL No. (NOTE 1.参照)

≡GL00001AB504100001A≡
表示モデル名 GL00001A
SERIAL No. (NOTE 1.参照)

3.PACKING
FOUR INDIVIDUALLY PACKED UNITS ARE TO BE PACKED ONE MASTER.

4.UPC-CODE IS PRINTED ON THE CARTON PACKING(IND)
CODE NO. 793276210937

68-29530Z49	C/N,CAUTION HI-TEMP	1
68-29530Z13	GRG,X110_LIMO-10 US	1
~~68-29530Z31~~	~~EVN LEAF AOIW~~	~~1~~
68-21627Z32	C/S-USA AOAM AOIW	1
68-29530Z26	C/N,NAVICARD LIMO US	1
68-29530Z73	C/N,URL X110_LIMO US	1
CONTENT CODE	CONTENT NAME	QTY
PAMPHLET		

09-30497Z02	ASSY,ANC-0089-01A	1
09-31165Z01	ASSY,AND-0208-01A	1
09-31130Z01	ASSY,AND-0202-01A	1
09-31132Z01	ASSY,AND-0204-01A	1
09-31131Z01	ASSY,AND-0203-01A	1
85-11368Z04	ASSY,YOP-5245AL06	1
09-22649Z02	ASSY,AND-0179-02A	1
03960820Y16	SCRMCH 5X8 ZN A	4
03960820Y17	SCRMCH 5X8 ZN A	8
07-30181Z01	BKT,HDMI ASSY	1
CONTENT CODE	CONTENT NAME	QTY
KIT		

T-DOCUMENT CODE	WL00001A-00
GROUP	CATIA V5
SUB GROUP	------

001	RELEASED FOR PRODUCTION	02-20-'15
002	[CP15052-BC] Change product factory name(A-5, B-5, B-6, C-2, D-6). Change PAMPHLET. Change 68-16340Z15 → 68-29530Z73(D-5). Delete 68-29530Z31(D-5). KMSH / NSANO / NSANO	05-15-'15

ISSUE	RELEASES AND REVISIONS MEMO (DRAWN BY)/(CHECKED BY)/(APPROVED BY)
	ALPINE ELECTRONICS, INC.
APPROVED BY	N.SANO
CHECKED BY	N.SANO
DRAWN BY	Y.SATO
PRODUCT CODE	WL00001A
T-DOCUMENT CODE	WL00001A-00

UNIT	---- MM	SCALE	1 : 1
THIRD ANGLE ORTHOGRAPHIC PROJECTION			
OWNERSHIP OF TOOL			
		☐ Y	☒ N
REVISIONS INDICATED BY CIRCLED LETTERS			

ASM			
DIMENSIONS	Lc3)	3to6<c12	12to
TOLERANCE	±0.15	±0.25	±0.4
		±1°	

ALL RIGHT ARE RESERVED

CONTENT CODE -- | ISSUE --
T-DOCUMENT NAME O/L,WL00001A
A1
DFM101-01

CONTENT DESCRIPTION (FINISH OR PROCESSING) | MATERIAL OR SOURCE OF CONTENT | MATERIAL TEMPER OR HARDNESS