

2 PRODUCT LABELING

PRODUCT LABELING (MOST DEVICES)

Figure 1. FCC ID Label


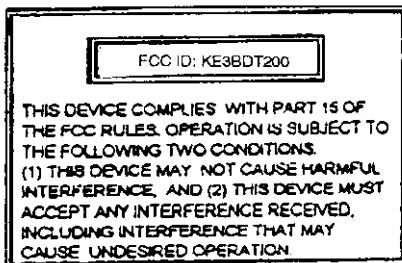


Figure 2. Location of Label on EUT

Actual size of label is 0.74" by 1.10" and will be placed
on BACK SIDE of product.

**** NOTE: If assembly drawings are available that show the placement of the label on the product, please provide a copy of these to US Tech.**

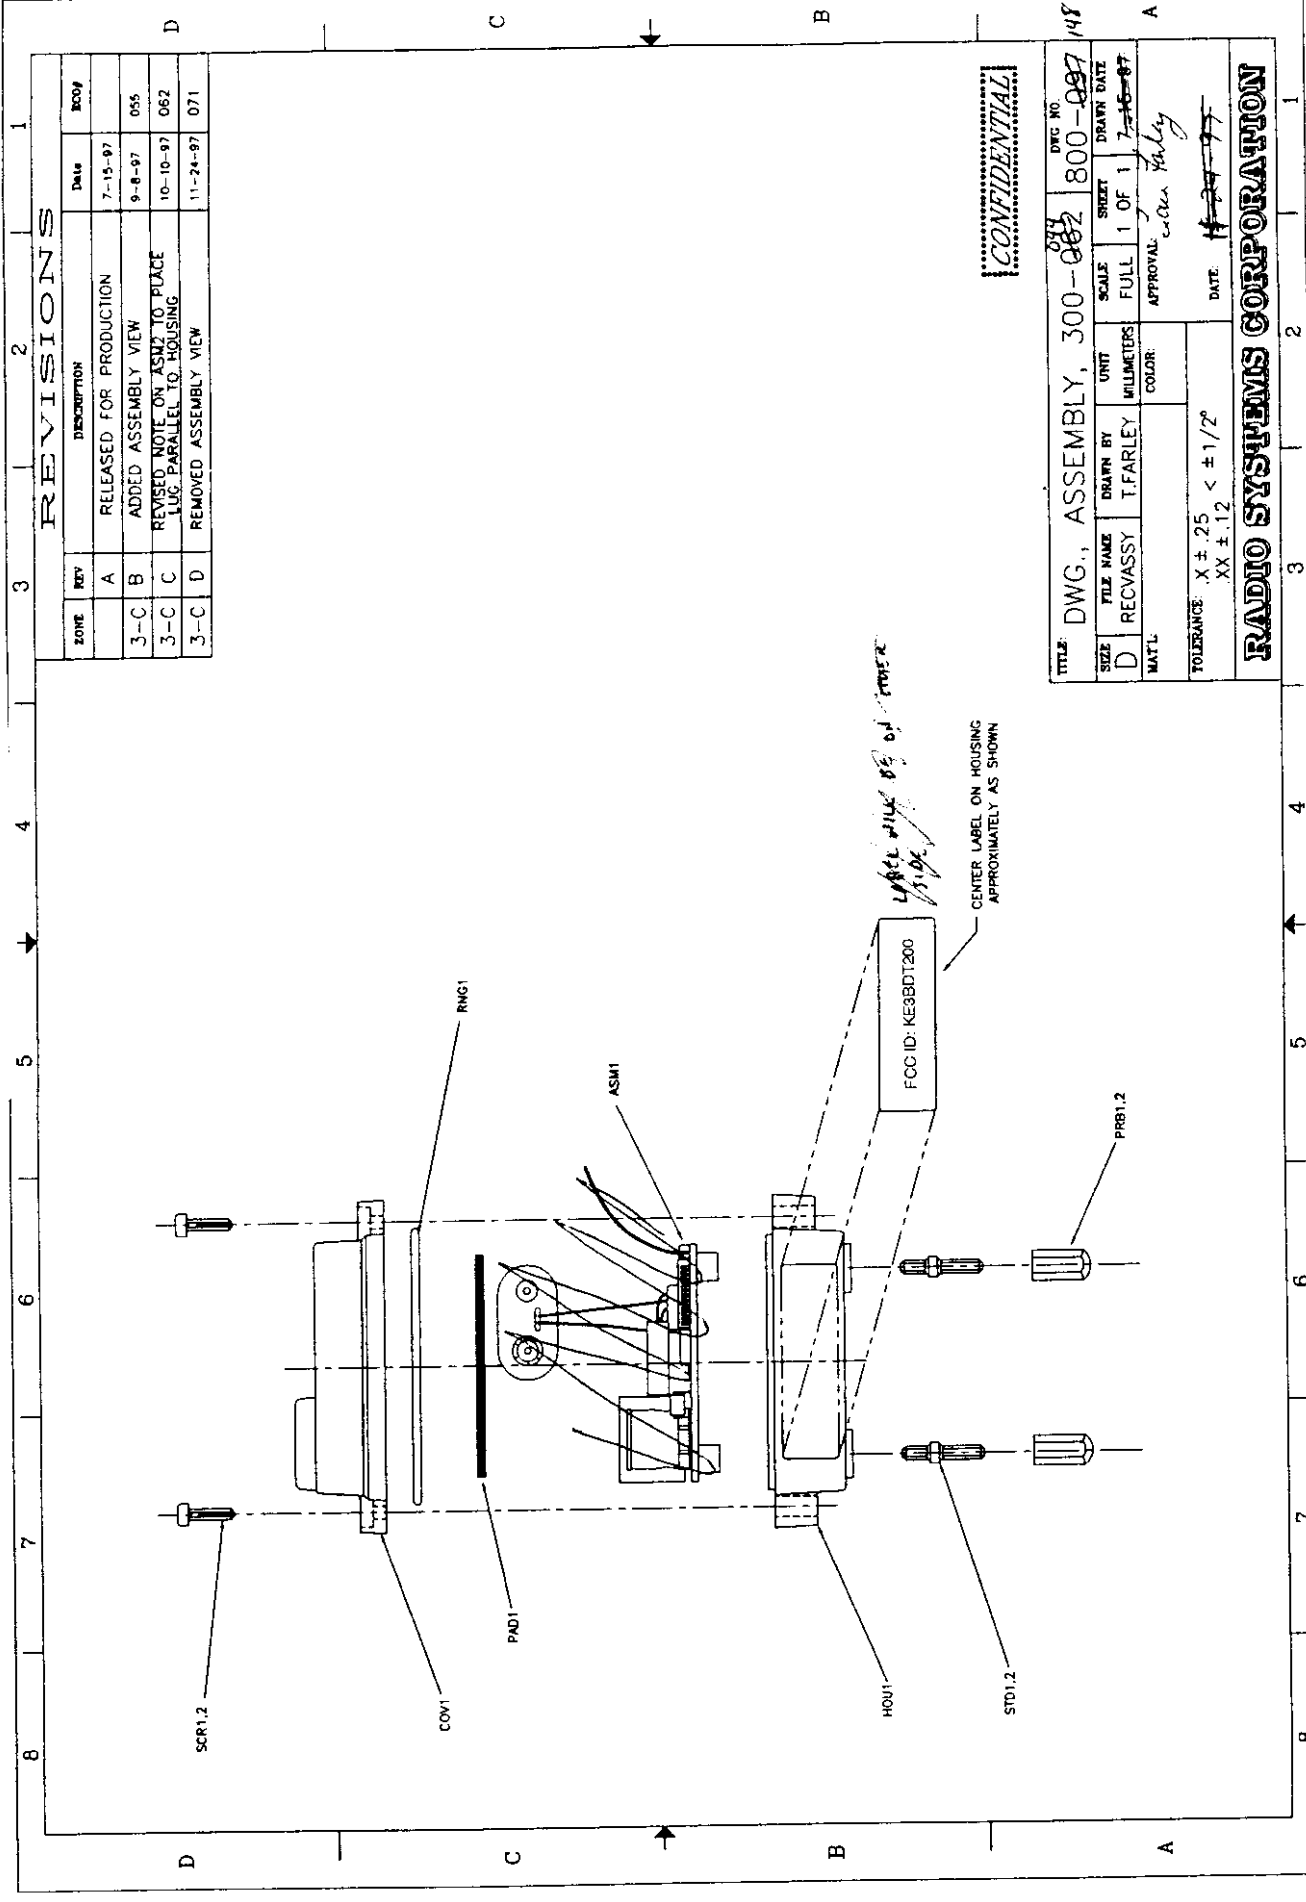

CONFIDENTIAL

TITLE: DWG., ASSEMBLY, 300-002		DWG NO	800-097
SIZE	FILE NAME	UNIT	SCALE
D	REC VASSY	T. FARLEY	FULL
MATL	DRIVEN BY	MILLIMETERS	1 OF 1
		COLOR:	APPROVAL: <i>can Farley</i>
TOLERANCE: X ± .25		DATE:	11-24-97
XX ± .12 < ± 1/2"			

RADIO SYSTEMS CORPORATION

REVISIONS

ZONE	REV	DESCRIPTION	DATE	ECO#
	A	RELEASED FOR PRODUCTION	7-15-97	
3-C	B	ADDED ASSEMBLY VIEW	9-8-97	055
3-C	C	REVISED NOTE ON ASM TO PLACE LUG PARALLEL TO HOUSING	10-10-97	062
3-C	D	REMOVED ASSEMBLY VIEW	11-24-97	071